



P★R★I★D★E
DISPOSAL COMPANY
P.O. Box 820 Sherwood, OR 97140
Phone: (503) 625-6177 Fax: (503) 625-6179

October 1, 2013

Brad Kilby, AICP, Planning Manager
22560 SW Pine St
Sherwood, OR 97140

Re: Pacific Family Dental parking lot expansion

We have reviewed the site plan for the enclosure for this site. The enclosure is described as a 20' x 10' area.

There are some additional requirements that need to be met that cannot be determined from the site plan:


- The enclosure needs to have inside measurements of 20' wide and 10' deep.
- There should be no center post at the access point in the center of the enclosure.
- The gates will need to allow for the full 20' needed to access the enclosure. They should be hinged in front of the enclosure walls to allow for the full 20' width. This will also allow for the 120 degree opening angle that is required.
- The gates need cane bolts and holes put in place for the gates to be locked in the open and closed position. The holes for the gates to be held open need to be at the full 120 degree opening angle.
- No roof on the enclosure

If you have any questions, feel free to contact me.

Sincerely,

Kristin Leichner
Pride Disposal Co.
(503) 625-6177
kristinl@pridedisposal.com

Exhibit F

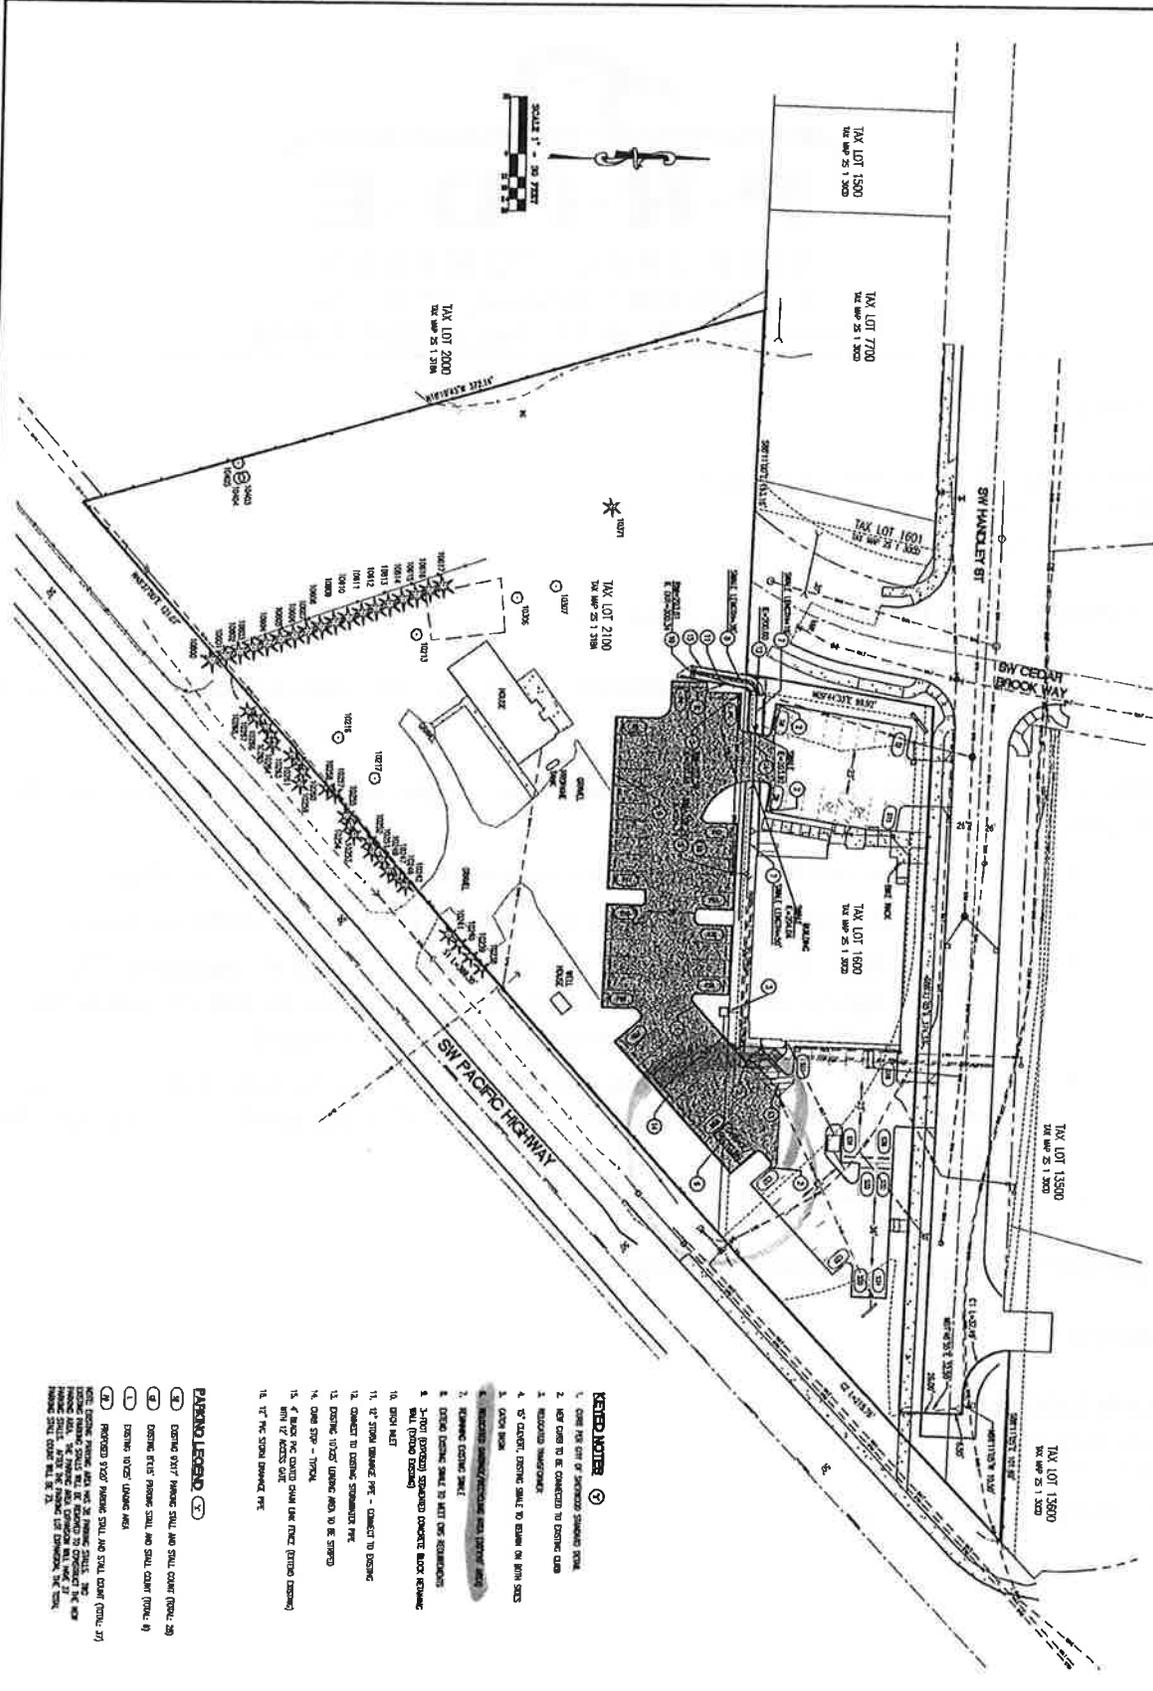

- NOTED NOTES**
1. CONFIRM THE LOCATION OF EXISTING UNDERGROUND UTILITIES.
 2. ALL UTILITIES TO BE CONNECTED TO EXISTING CURB.
 3. RELOCATED UNDERGROUND UTILITIES.
 4. 30" DIAMETER EXISTING SEWER TO REMAIN ON BOTH SIDES.
 5. EXISTING 18" WATER MAIN.
 6. EXISTING 12" GAS MAIN.
 7. EXISTING 12" ELECTRIC MAIN.
 8. EXISTING 12" TELEPHONE MAIN.
 9. EXISTING 12" CABLE MAIN.
 10. EXISTING 12" FIBER OPTIC MAIN.
 11. EXISTING 12" RAINWATER MAIN.
 12. EXISTING 12" STORM SEWER MAIN.
 13. EXISTING 12" SANITARY MAIN.
 14. EXISTING 12" FIRE MAIN.
 15. EXISTING 12" WATER MAIN.
 16. EXISTING 12" GAS MAIN.
 17. EXISTING 12" ELECTRIC MAIN.
 18. EXISTING 12" TELEPHONE MAIN.
 19. EXISTING 12" CABLE MAIN.
 20. EXISTING 12" FIBER OPTIC MAIN.
 21. EXISTING 12" RAINWATER MAIN.
 22. EXISTING 12" STORM SEWER MAIN.
 23. EXISTING 12" SANITARY MAIN.
 24. EXISTING 12" FIRE MAIN.
 25. EXISTING 12" WATER MAIN.
 26. EXISTING 12" GAS MAIN.
 27. EXISTING 12" ELECTRIC MAIN.
 28. EXISTING 12" TELEPHONE MAIN.
 29. EXISTING 12" CABLE MAIN.
 30. EXISTING 12" FIBER OPTIC MAIN.
 31. EXISTING 12" RAINWATER MAIN.
 32. EXISTING 12" STORM SEWER MAIN.
 33. EXISTING 12" SANITARY MAIN.
 34. EXISTING 12" FIRE MAIN.
 35. EXISTING 12" WATER MAIN.
 36. EXISTING 12" GAS MAIN.
 37. EXISTING 12" ELECTRIC MAIN.
 38. EXISTING 12" TELEPHONE MAIN.
 39. EXISTING 12" CABLE MAIN.
 40. EXISTING 12" FIBER OPTIC MAIN.
 41. EXISTING 12" RAINWATER MAIN.
 42. EXISTING 12" STORM SEWER MAIN.
 43. EXISTING 12" SANITARY MAIN.
 44. EXISTING 12" FIRE MAIN.
 45. EXISTING 12" WATER MAIN.
 46. EXISTING 12" GAS MAIN.
 47. EXISTING 12" ELECTRIC MAIN.
 48. EXISTING 12" TELEPHONE MAIN.
 49. EXISTING 12" CABLE MAIN.
 50. EXISTING 12" FIBER OPTIC MAIN.

- PARKING LEGEND**
- (X) EXISTING 30'x60' PARKING SPACES AND STALLS (TOTAL: 25)
 - (O) EXISTING 6'x8' PARKING SPACES AND STALLS (TOTAL: 10)
 - (S) EXISTING 10'x12' LOADING AREAS
 - (P) PROPOSED 30'x60' PARKING SPACES AND STALLS (TOTAL: 37)
 - (R) PROPOSED 6'x8' PARKING SPACES AND STALLS (TOTAL: 15)
 - (L) PROPOSED 10'x12' LOADING AREAS (TOTAL: 2)
 - (B) PROPOSED 10'x12' BICYCLE SPACES (TOTAL: 10)
 - (T) PROPOSED 10'x12' TRUCK SPACES (TOTAL: 2)
 - (V) PROPOSED 10'x12' VAN SPACES (TOTAL: 2)
 - (C) PROPOSED 10'x12' CABINETS (TOTAL: 2)
 - (D) PROPOSED 10'x12' DRUGS (TOTAL: 2)
 - (E) PROPOSED 10'x12' EQUIPMENT (TOTAL: 2)
 - (F) PROPOSED 10'x12' FURNITURE (TOTAL: 2)
 - (G) PROPOSED 10'x12' GARDEN (TOTAL: 2)
 - (H) PROPOSED 10'x12' HALLS (TOTAL: 2)
 - (I) PROPOSED 10'x12' ISLANDS (TOTAL: 2)
 - (J) PROPOSED 10'x12' JACOBS (TOTAL: 2)
 - (K) PROPOSED 10'x12' KITCHENS (TOTAL: 2)
 - (L) PROPOSED 10'x12' LIVING (TOTAL: 2)
 - (M) PROPOSED 10'x12' MEETINGS (TOTAL: 2)
 - (N) PROPOSED 10'x12' NESTS (TOTAL: 2)
 - (O) PROPOSED 10'x12' OFFICES (TOTAL: 2)
 - (P) PROPOSED 10'x12' OUTDOOR (TOTAL: 2)
 - (Q) PROPOSED 10'x12' PLANTING (TOTAL: 2)
 - (R) PROPOSED 10'x12' RECEPTION (TOTAL: 2)
 - (S) PROPOSED 10'x12' RESTROOMS (TOTAL: 2)
 - (T) PROPOSED 10'x12' RETAIL (TOTAL: 2)
 - (U) PROPOSED 10'x12' STORAGE (TOTAL: 2)
 - (V) PROPOSED 10'x12' STUDIOS (TOTAL: 2)
 - (W) PROPOSED 10'x12' THEATRE (TOTAL: 2)
 - (X) PROPOSED 10'x12' TRADING (TOTAL: 2)
 - (Y) PROPOSED 10'x12' TRAINING (TOTAL: 2)
 - (Z) PROPOSED 10'x12' VISITOR (TOTAL: 2)

	ENGINEERING - PLANNING SHERWOOD - PORTLAND 1000 SHERWOOD AVENUE SHERWOOD, OREGON 97139 PHONE: (503) 835-1111 FAX: (503) 835-1112	PACIFIC FAMILY DENTAL PARKING LOT EXPANSION SHERWOOD OREGON TAX LOTS 1300 AND 1350	PRELIMINARY SITE AND UTILITY PLAN OREGON WASHINGTON COUNTY TAX MAP 25 1 3000 AND 25 1 3104
	SHEET 2771		